

McDONALD'S USA, LLC.

PARCEL INFORMATION

PARCEL NUMBER: 661700026.00
EXISTING ZONING: REGIONAL COMMERCIAL

HEALTH REQUIREMENTS

- 1. DURING CONSTRUCTION THE LOBBY WILL BE SHUT DOWN TO CUSTOMERS WHILE THE DRIVE-THRU WILL STAY OPEN...
2. DURING CONSTRUCTION A TEMPORARY WALL OF PLASTIC TAPED OFF FLOOR TO CEILING WILL BE PROVIDE TO PROTECT DEBRIS FROM ENTERING THE KITCHEN.

PROJECT TEAM

CONSTRUCTION MANAGER:

McDONALD'S USA, LLC.
4643 SOUTH ULSTER STREET, SUITE 1300
DENVER, COLORADO 80237
PHONE: (480) 417-6764
CONTACT: Bob Pohlman
EMAIL: bob.pohlman@sevansolutions.com

ARCHITECT:

PM DESIGN GROUP, INC.
76 EAST MITCHELL DRIVE
PHOENIX, ARIZONA 85012
PHONE: (602) 457-4537
CONTACT: STEVEN ALBRECHT
EMAIL: salbrecht@pmdginc.com

ELECTRICAL:

ROBISON ENGINEERING
19401 40th AVENUE W, SUITE 302
LYNWOOD, WASHINGTON 98036
PHONE: (260) 364-3343
CONTACT: CHAU NGUYEN

DRAWING INDEX

- 1. CV.0 COVER SHEET
2. AD.1 SITE PLAN
3. AO.2 CONTEXT PLANDetails
4. AT.0 FLOOR PLAN
5. A2.0 PROPOSED EXTERIOR ELEVATIONS
6. A2.1 COLORED RENDERING

SITE INFO

STATE SITE CODE: 043-0267
STORE NUMBER: 31710
ADDRESS: 173 EAST STATE ROAD #73, SARATOGA SPRINGS, UT, 84043
COUNTY: UTAH

BUILDING DATA

DATE BUILT: FEBRUARY, 2007
OCCUPANCY: A-2
CONSTRUCTION TYPE: VB
NUMBER OF STORIES: 1
BUILDING S.F.: 3,817 S.F.
ADDITION S.F.: 1,027 S.F.
TOTAL S.F.: 4,844 SF.

BUILDING CODES

BUILDING: 2015 INTERNATIONAL BUILDING CODE
MECHANICAL: 2015 INTERNATIONAL MECHANICAL CODE
FIRE: 2015 INTERNATIONAL FIRE CODE
ENERGY: 2015 INTERNATIONAL ENERGY CONSERVATION CODE
PLUMBING: 2015 INTERNATIONAL PLUMBING CODE
ELECTRICAL: 2017 NATIONAL ELECTRICAL CODE

LIFE SAFETY

EMERGENCY LIGHTING: X YES NO
EXIT SIGNS: X YES NO
FIRE ALARM AND SMOKE DETECTION: YES X NO
PANIC HARDWARE: X YES NO
FIRE SPRINKLERS: YES X NO


SCOPE OF WORK

- MODIFICATIONS TO EXISTING McDONALD'S RESTAURANT:
BUILDING:
• DEMOLITION OF EXISTING PUBLIC AREA INTERIOR PONY WALLS, SEATING AND FINISHES.
• DEMOLITION OF WINDOWS ON EXTERIOR FRONT(WEST) SIDE OF BUILDING FOR NEW ADDITION.
• MODIFICATION TO EXISTING CUSTOMER SERVICE COUNTER.
• ADDITION OF 908 SQ. FT. PLAY PLACE WITH NEW EXTERIOR FACADE.
• ADDITION OF 88 SQ. FT. SECONDARY ENTRANCE VESTIBULE.
• NEW FLOORING, WALL DECOR, PAINT AND LIGHTING IN PUBLIC AREA.
• NEW INTERIOR WALL COLUMNS.
• NEW ELECTRICAL POWER FOR NEW INTERACTIVE GAMES AND FOOD ORDER KIOSK.
• NEW CEILING IN REMODELED AREAS
• RELOCATED CEILING DIFFUSERS, DUCTWORK TO BE ADJUSTED TO ACCOMMODATE NEW CEILING LAYOUT.
• THE KITCHEN / FOOD PREP AREAS ARE TO "REMAIN AS IS".
• NEW EXTERIOR FIRE RISER ROOM.

DEFERRED SUBMITTALS

- FIRE SPINKLERS
• FIRE ALARM AND SMOKE DETECTION

VICINITY MAP

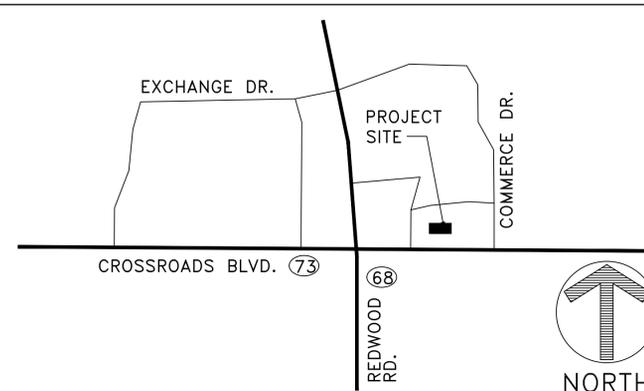

DRAWING SYMBOLS


- KEYED NOTE: (X) ->
DETAIL REFERENCE: (XX) TOP # = DETAIL #, (XX) BOTTOM # = SHEET #
SECTION CUT REFERENCE: (XX) TOP # = DETAIL #, (XX) BOTTOM # = SHEET #
REVISION NUMBER: (A)

ABBREVIATIONS

Table with 4 columns: F.E., MAX., MIN., O.C., SIM., TYP., N.T.S., FIRE EXTINGUISHER, V.I.F., F.R.P., VERIFY IN FIELD, FIBER REINFORCED PLASTIC

GENERAL BUILDING NOTES


- 1. NOTIFY ARCHITECT OF ANY DISCREPANCIES BETWEEN ARCHITECTURAL AND ELECTRICAL DRAWINGS AS WELL AS ANY DISCREPANCIES BETWEEN THE ARCHITECTURAL PLANS AND ANY EXISTING CONDITIONS.
2. CONTRACTOR TO COORDINATE DISCONNECT OF ALL UTILITIES PRIOR TO ANY DEMOLITION.
3. CONTRACTOR TO REMOVE ALL CONSTRUCTION DEBRIS AND DISPOSE OF IT IN ACCORDANCE WITH CITY AND COUNTY REGULATIONS.
4. CONTRACTOR TO PROTECT ALL PUBLIC BUILDING AREAS ALONG THE ROUTE OF TRAVEL PRIOR TO THE COMMENCEMENT OF DEMOLITION.
5. CONTRACTOR TO CLEAN UP PUBLIC AREAS ALONG THE ROUTE OF TRAVEL EACH DAY AND WHENEVER DEBRIS, DUST, ETC. BECOMES EXCESSIVE.
6. FIELD VERIFICATION OF EXISTING CONDITIONS AND SPECIFIC QUANTITIES OF DEMOLITION ARE THE RESPONSIBILITY OF THE CONTRACTOR.
7. ALL DIMENSIONS SHOWN TO BE EXISTING SHALL BE FIELD VERIFIED BY THE CONTRACTOR PRIOR TO DEMOLITION.
8. CONTRACTOR SHALL PROVIDE ALL TEMPORARY BRACING AS REQUIRED TO MAINTAIN STRUCTURAL STABILITY OF THE EXISTING STRUCTURE DURING ALL PHASES OF CONSTRUCTION.
9. IF THE CONTRACTOR ENCOUNTERS ANY HAZARDOUS MATERIALS DURING DEMOLITION OR CONSTRUCTION, CONSTRUCTION TO BE SUSPENDED IMMEDIATELY AND McDONALD'S PROJECT MANAGER SHALL BE NOTIFIED BEFORE PROCEEDING.
10. ALL DEMOLITION SHALL BE CARRIED OUT IN A SAFE MANNER IN ACCORDANCE WITH OSHA REGULATIONS.
11. SEE DECOR FOR INTERIOR PARTITION TYPES. WALL PARTITIONS ARE TYPE 'A' UNLESS NOTED OTHERWISE.
12. SEE DECOR DRAWINGS FOR ROOM FINISHES.
13. MAXIMUM OCCUPANCY SIGN TO BE POSTED PER LOCAL CODE. SIGN PURCHASED AND INSTALLED BY GENERAL CONTRACTOR.
14. COORDINATE ALL REQUIRED BLOCKING AND PROPER INSTALLATION HEIGHTS FOR WALL HUNG EQUIPMENT AND SHELVEING.
15. PROVIDE TACTILE EXIT SIGN ADHERED TO SIDE-LITE (TYP.) FOR ENTRY DOORS.
16. VERIFY INTERNATIONAL SYMBOL OF ACCESSIBILITY IS AT ALL ENTRANCE AND EXIT DOORS, IF NOT PLEASE PROVIDE.
17. INTERIOR DIMENSIONS ARE TO FACE OF FINISH.
18. GENERAL CONTRACTOR TO PURCHASE ACCESSIBILITY SIGNAGE PACKAGE AND INSTALL SIGNS AT LOCATIONS AND POSITIONS INDICATED IN PACKAGE OR AS REQUIRED BY LOCAL CODES. SIGNAGE PACKAGE SUPPLIED BY: FORREST PERMA-SIGN 1-800-214-8765 9292 1ST ST., BOX 588 WWW.FORRESTPERMASIGNS.COM NEW ROCHELLE, NEW YORK 10802.
19. VERIFY WITH McDONALD'S CONSTRUCTION MANAGER TO EITHER ADJUST EXISTING CLOSER OR REPLACE WITH NEW CLOSER UNIT TO MEET A.D.A. DESIGN GUIDELINES 404.2.8 CLOSING SPEED OF 5 SECONDS MINIMUM FROM OPEN POSITION OF 90 DEGREES TO A POSITION OF 12 DEGREES FROM LATCH.
20. ADJUST OR REPLACE DOOR HARDWARE TO COMPLY WITH A.D.A. DESIGN GUIDELINES 309.4 STATING ALL OPERABLE PARTS SHALL BE OPERABLE WITH ONE HAND AND SHALL NOT REQUIRE TIGHT GRASPING, PINCHING, OR TWISTING OF THE WRIST. THE FORCE REQUIRED TO ACTIVATE OPERABLE PARTS SHALL BE 5 LBS. MINIMUM.
21. ALL WINDOWS ARE FIXED AND NON-OPERABLE WITH EXCEPTIONS TO THE CASHIER AND PRESENTER WINDOWS.
22. WHEN CEILING INTERRUPTIONS OCCUR, SUCH AS PARTITIONS, FURR DOWNS ETC., CONTRACTOR SHALL CHECK AND VERIFY THAT WORK IS BUILDABLE AS SHOWN BEFORE PROCEEDING WITH CONSTRUCTION. SHOULD THERE BE ANY QUESTIONS, CONTRACTOR IS RESPONSIBLE FOR OBTAINING A CLARIFICATION FROM THE ARCHITECT IN WRITING BEFORE PROCEEDING WITH THE WORK IN QUESTION OR RELATED WORK.
23. ALL NEW CEILING FIXTURES, SWITCHES, AND MOTION SENSORS SHALL MATCH BUILDING STANDARD UNLESS NOTED OTHERWISE.
24. LOCATE ALL LIGHT FIXTURES, SPEAKERS, ACCESS PANELS, LIFE-SAFETY FIXTURES, ETC., IN STRAIGHT LINES AND IN CENTER OF CEILING TILES UNLESS NOTED OTHERWISE.
25. THERE SHALL BE NO COMBUSTIBLE MATERIALS IN THE PLENUM SPACE INCLUDING ALUMINUM FLEX, ALUMINUM CONDUITS, AND POT METAL CONNECTORS. ALL CONNECTORS SHALL BE STEEL.
26. ALL NEW CONDUITS, BOXES, DUCTS, HVAC UNITS, PIPES, ETC. SHALL BE INSTALLED AS HIGH AS POSSIBLE, NOT LOWER THAN 8" ABOVE LINE OF FINISH CEILING.
27. WHEN FIXTURES INTERRUPT MAIN RUNNERS, CUT AND REINFORCE AS REQUIRED.
28. ALL LED FIXTURE LAMPS SHALL BE IDENTICAL FROM ONE MANUFACTURER.
29. PROVIDE EMERGENCY LIGHTING LEVELS AS REQUIRED BY CODE.
30. IT IS THE RESPONSIBILITY OF CONTRACTOR TO MAKE SURE HVAC ALIGNS WITH T-BAR CEILING.
31. THE CONTRACTOR SHALL PROVIDE RECORD DOCUMENTS OF ALL WORK PREFORMED AND SHALL INDICATE ANY DEVIATIONS FROM THE DESIGN DOCUMENTS AS WELL AS THE LOCATION OF ALL WORK WHICH IS HIDDEN BY SUBSEQUENT CONSTRUCTION. THE RECORD DOCUMENTS SHALL BE GIVEN TO THE OWNER AT COMPLETION OF TENANT CONSTRUCTION PRIOR TO APPLICATION FOR FINAL PAYMENT.
32. GENERAL CONTRACTOR TO FOLLOW McDONALD'S SPECIFICATION BOOK.
33. TEMP, HUMIDITY AND CO2 SENSORS TO BE PROTECTED IN PLACE. THEY ARE TYPICALLY LOCATED NEAR RESTROOM AND ABOVE SSSB AND PLAY PLACE.

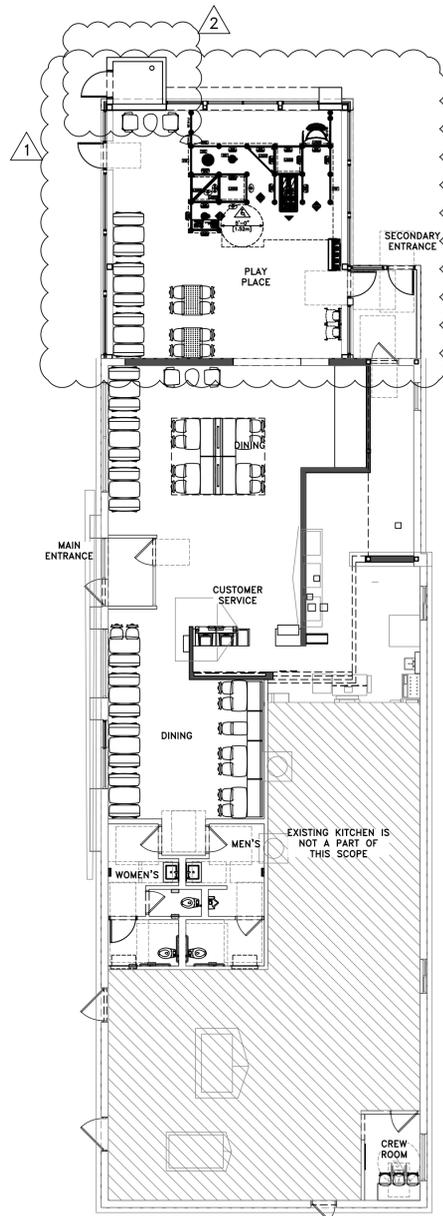

THIS DRAWING IS FOR REFERENCE ONLY



Vertical sidebar containing revision table, professional of record information (PM Design Architectural Solutions Group), architect information (Hemant Modi), and project details (McDonald's USA, LLC, Saratoga Springs).

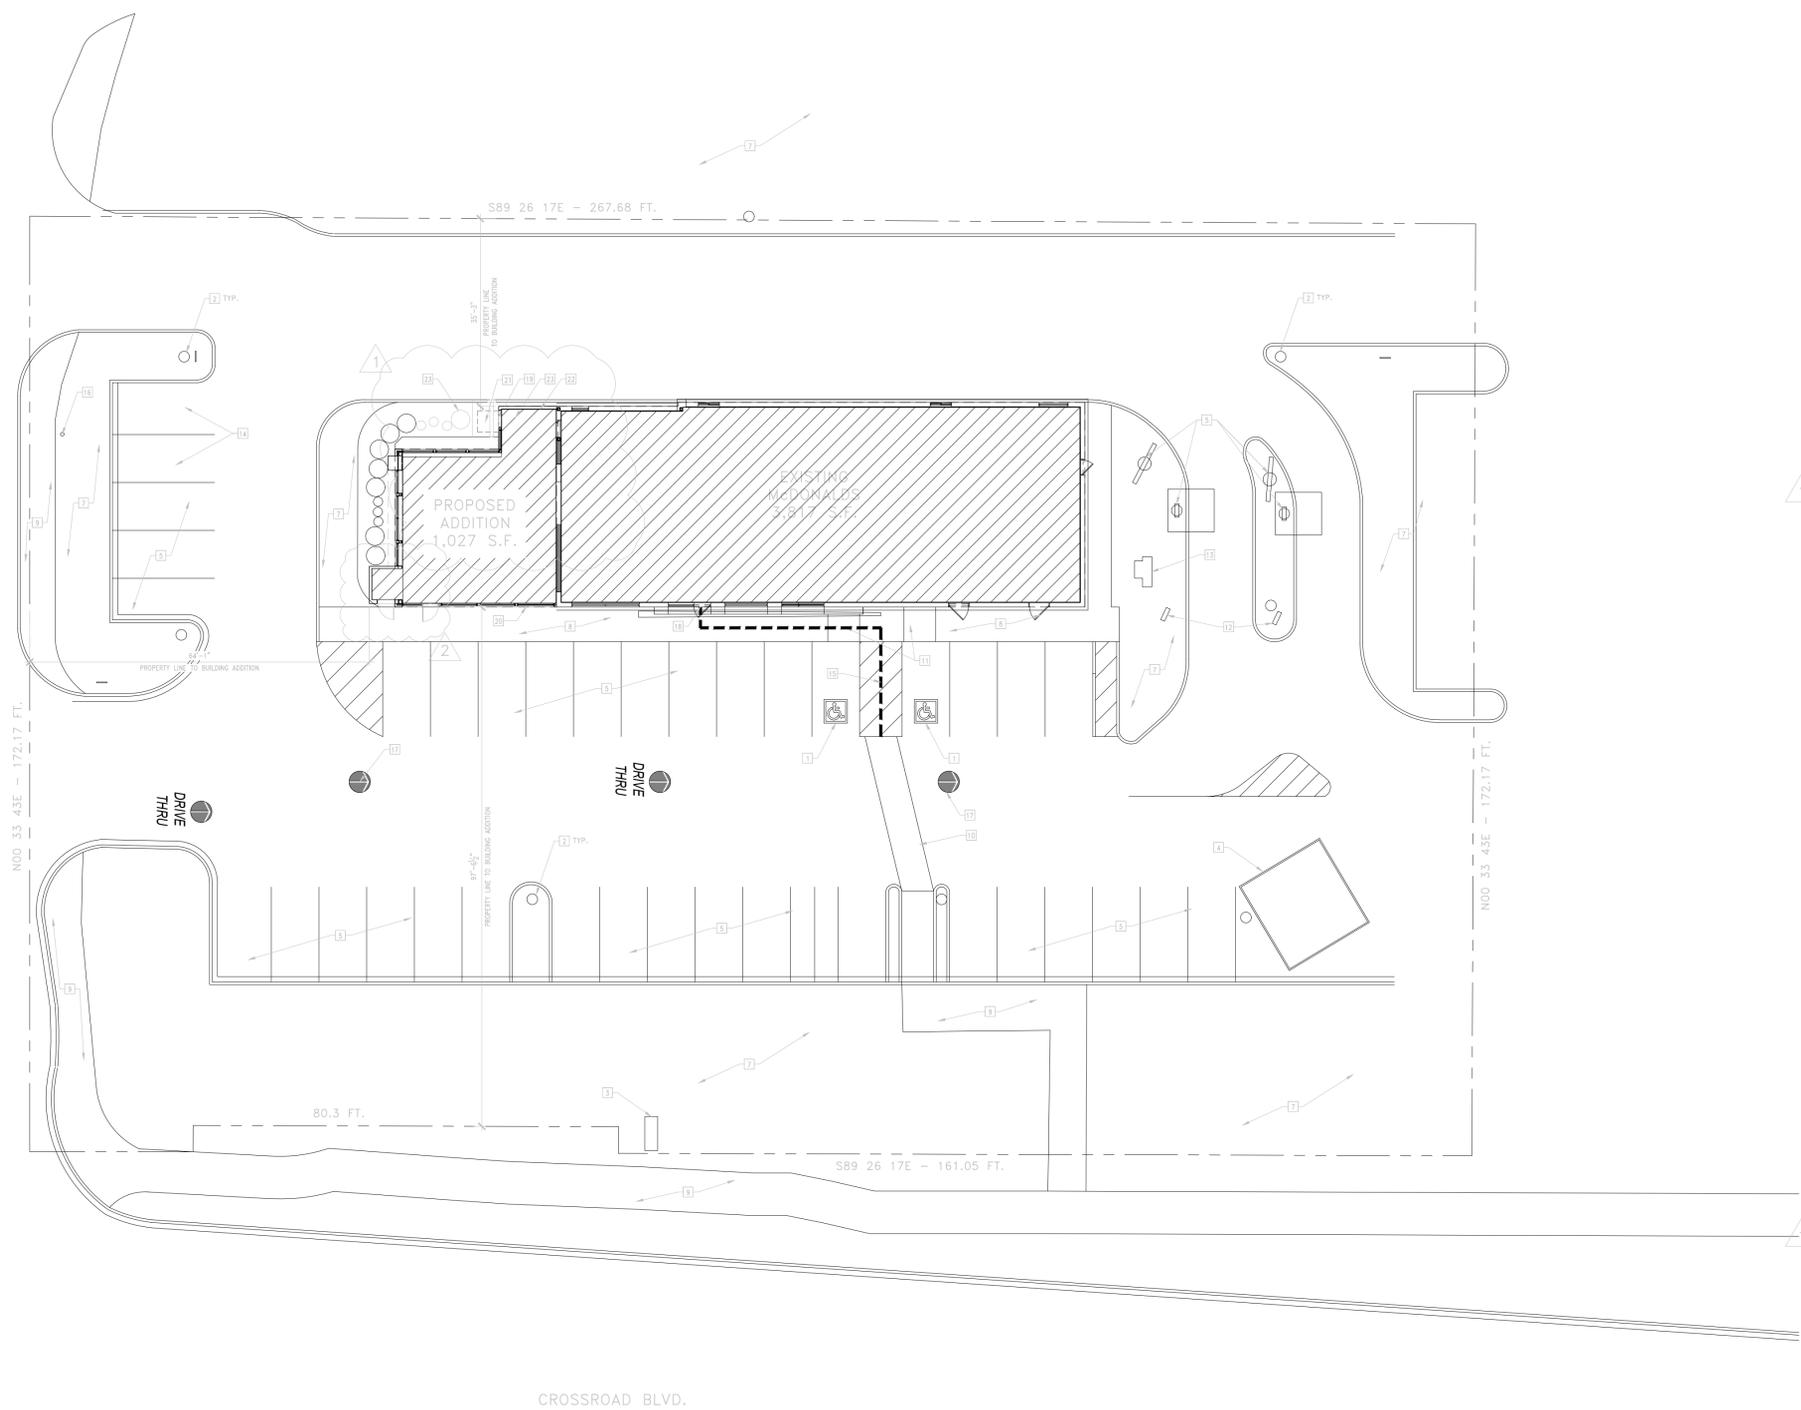

KEYED NOTES

MARK	DESCRIPTION OF WORK
1	EXISTING A.D.A. PARKING AND SIGNAGE TO REMAIN.
2	EXISTING SITE LIGHT TO REMAIN.
3	EXISTING MONUMENT SIGN TO REMAIN.
4	EXISTING TRASH ENCLOSURE TO REMAIN.
5	EXISTING PARKING STALL TO REMAIN (TYP.).
6	EXISTING ORDER POINT AND MENU BOARD.
7	EXISTING LANDSCAPE AREA TO REMAIN.
8	EXISTING SIDEWALK TO REMAIN.
9	EXISTING PUBLIC SIDEWALK.
10	EXISTING STONE PATHWAY TO REMAIN.
11	EXISTING A.D.A. RAMP TO REMAIN.
12	EXISTING PRE-BROWSE BOARD TO REMAIN.
13	EXISTING TRANSFORMER TO REMAIN.
14	EXISTING PULL-FORWARD PARKING AND SIGNAGE TO REMAIN.
15	EXISTING ACCESSIBLE PATH OF TRAVEL AND SIGN, INDICATING PATH OF TRAVEL FROM PUBLIC RIGHT-OF-WAY TO ACCESSIBLE BUILDING ENTRANCE
16	EXISTING FIRE HYDRANT
17	EXISTING PAINTED PAVEMENT DIRECTIONAL SIGNAGE, TYP.
18	EXISTING MAIN ENTRANCE/EXIT DOOR TO REMAIN.
19	NEW ENTRANCE AT NEW VESTIBULE
20	PROPOSED PLAYPLACE TO BE ATTACHED TO EXISTING BUILDING
21	INFILL CONCRETE PATTERN FOR NEW ACCESSIBLE ROUTE TO SECONDARY ENTRANCE.
22	REMOVE EXISTING GUARDRAIL ALONG SIDEWALK.
23	REMOVE AND RELOCATE SINGLE SHRUB TO PLANTER AT EDGE OF NEW SIDEWALK.

PROJECT DATA

APPLICANT / OWNER: MCDONALD'S USA, LLC
 17550 N. PERIMETER DRIVE
 SUITE 400
 SCOTTSDALE AZ 85255
 CONTACT: SCOTT AUDSLEY
 PHONE: (480) 417-6764
 EMAIL: KURTIS.DeMARSE@US.MCD.COM

ARCHITECT: PM DESIGN GROUP, INC.
 76 E. MITCHELL DR.
 PHOENIX, AZ 85012
 CONTACT: STEVEN ALBRECHT
 PHONE: (602) 457-4537
 EMAIL: SALBRECHT@PMDGINC.COM

ADDRESS: 173 E. CROSSROADS BLVD.
 SARATOGA SPRINGS, UT 84043

SCOPE OF WORK:
 ADDING PROPOSED 1,027 SQ. FT. PLAY PLACE, VESTIBULE AND FIRE RISER ROOM TO EXISTING MCDONALD'S RESTAURANT. FACADE WILL MATCH EXISTING BUILDING.

SITE DATA

SITE ACREAGE AREA: 45,738 S.F. = 1.05 AC
 PARCEL ID: 66:170:0026
 EXISTING BUILDING FOOTPRINT: 3,817 S.F.
 EXISTING BUILDING COVERAGE: 3,817 S.F. / 45,738 S.F. = 8%
 PROPOSED BUILDING ADDITION: 1,027 S.F.
 TOTAL EXISTING/PROPOSED BUILDING: 4,844 S.F.
 TOTAL BUILDING COVERAGE: 4,844 S.F. / 45,738 S.F. = 11%
 EXISTING ZONING: RC - REGIONAL COMMERCIAL
 EXISTING BUILDING HEIGHT: 21'-8" (1) STORY
 PROPOSED BUILDING HEIGHT: 21'-11" (1) STORY

PARKING (EXISTING TO REMAIN):
 EXISTING PARKING: 36 PARKING SPACES
 EXISTING ACCESSIBLE PARKING: 2 ACCESSIBLE SPACES
 TOTAL EXISTING PARKING: 38 PARKING SPACES

PARKING REQUIRED: 4,844 S.F./250 = 20 PARKING SPACES
 ACCESSIBLE PARKING REQUIRED: (1) ACCESSIBLE SPACE.

VICINITY MAP



EXISTING SITE PLAN SCALE: 1"=10'-0"

REV	DATE	DESCRIPTION
1	09-26-19	PLANNING COMMENTS
2	10-10-19	OWNER REVISIONS

PROFESSIONAL OF RECORD:

PM DESIGN
 Architectural Solutions Group

HEMANT MODI, ARCHITECT
 hmodi@pmdginc.com

STEVEN ALBRECHT, SR. JOB CAPTAIN
 salbrecht@pmdginc.com

76 EAST MITCHELL DRIVE,
 PHOENIX, ARIZONA 85012
 PHONE (623) 432-0596

EXP. 05/31/2020

PREPARED FOR: McDonald's USA, LLC

DRAWN BY: SALBRECHT

CHECKED BY: JCONSBRUCK

DATE ISSUED: 01-31-19

PROJECT#: MCD18018.0


TITLE: McDonald's #31710 SARATOGA SPRINGS

DESCRIPTION: INTERIOR EOTF

PLANNING REVIEW: 10/03/19

SITE ADDRESS: 043-0267 173 E STATE ROAD 73, SARATOGA SPRINGS, UT 84043

SHEET NO. **A0.1** SITE PLAN

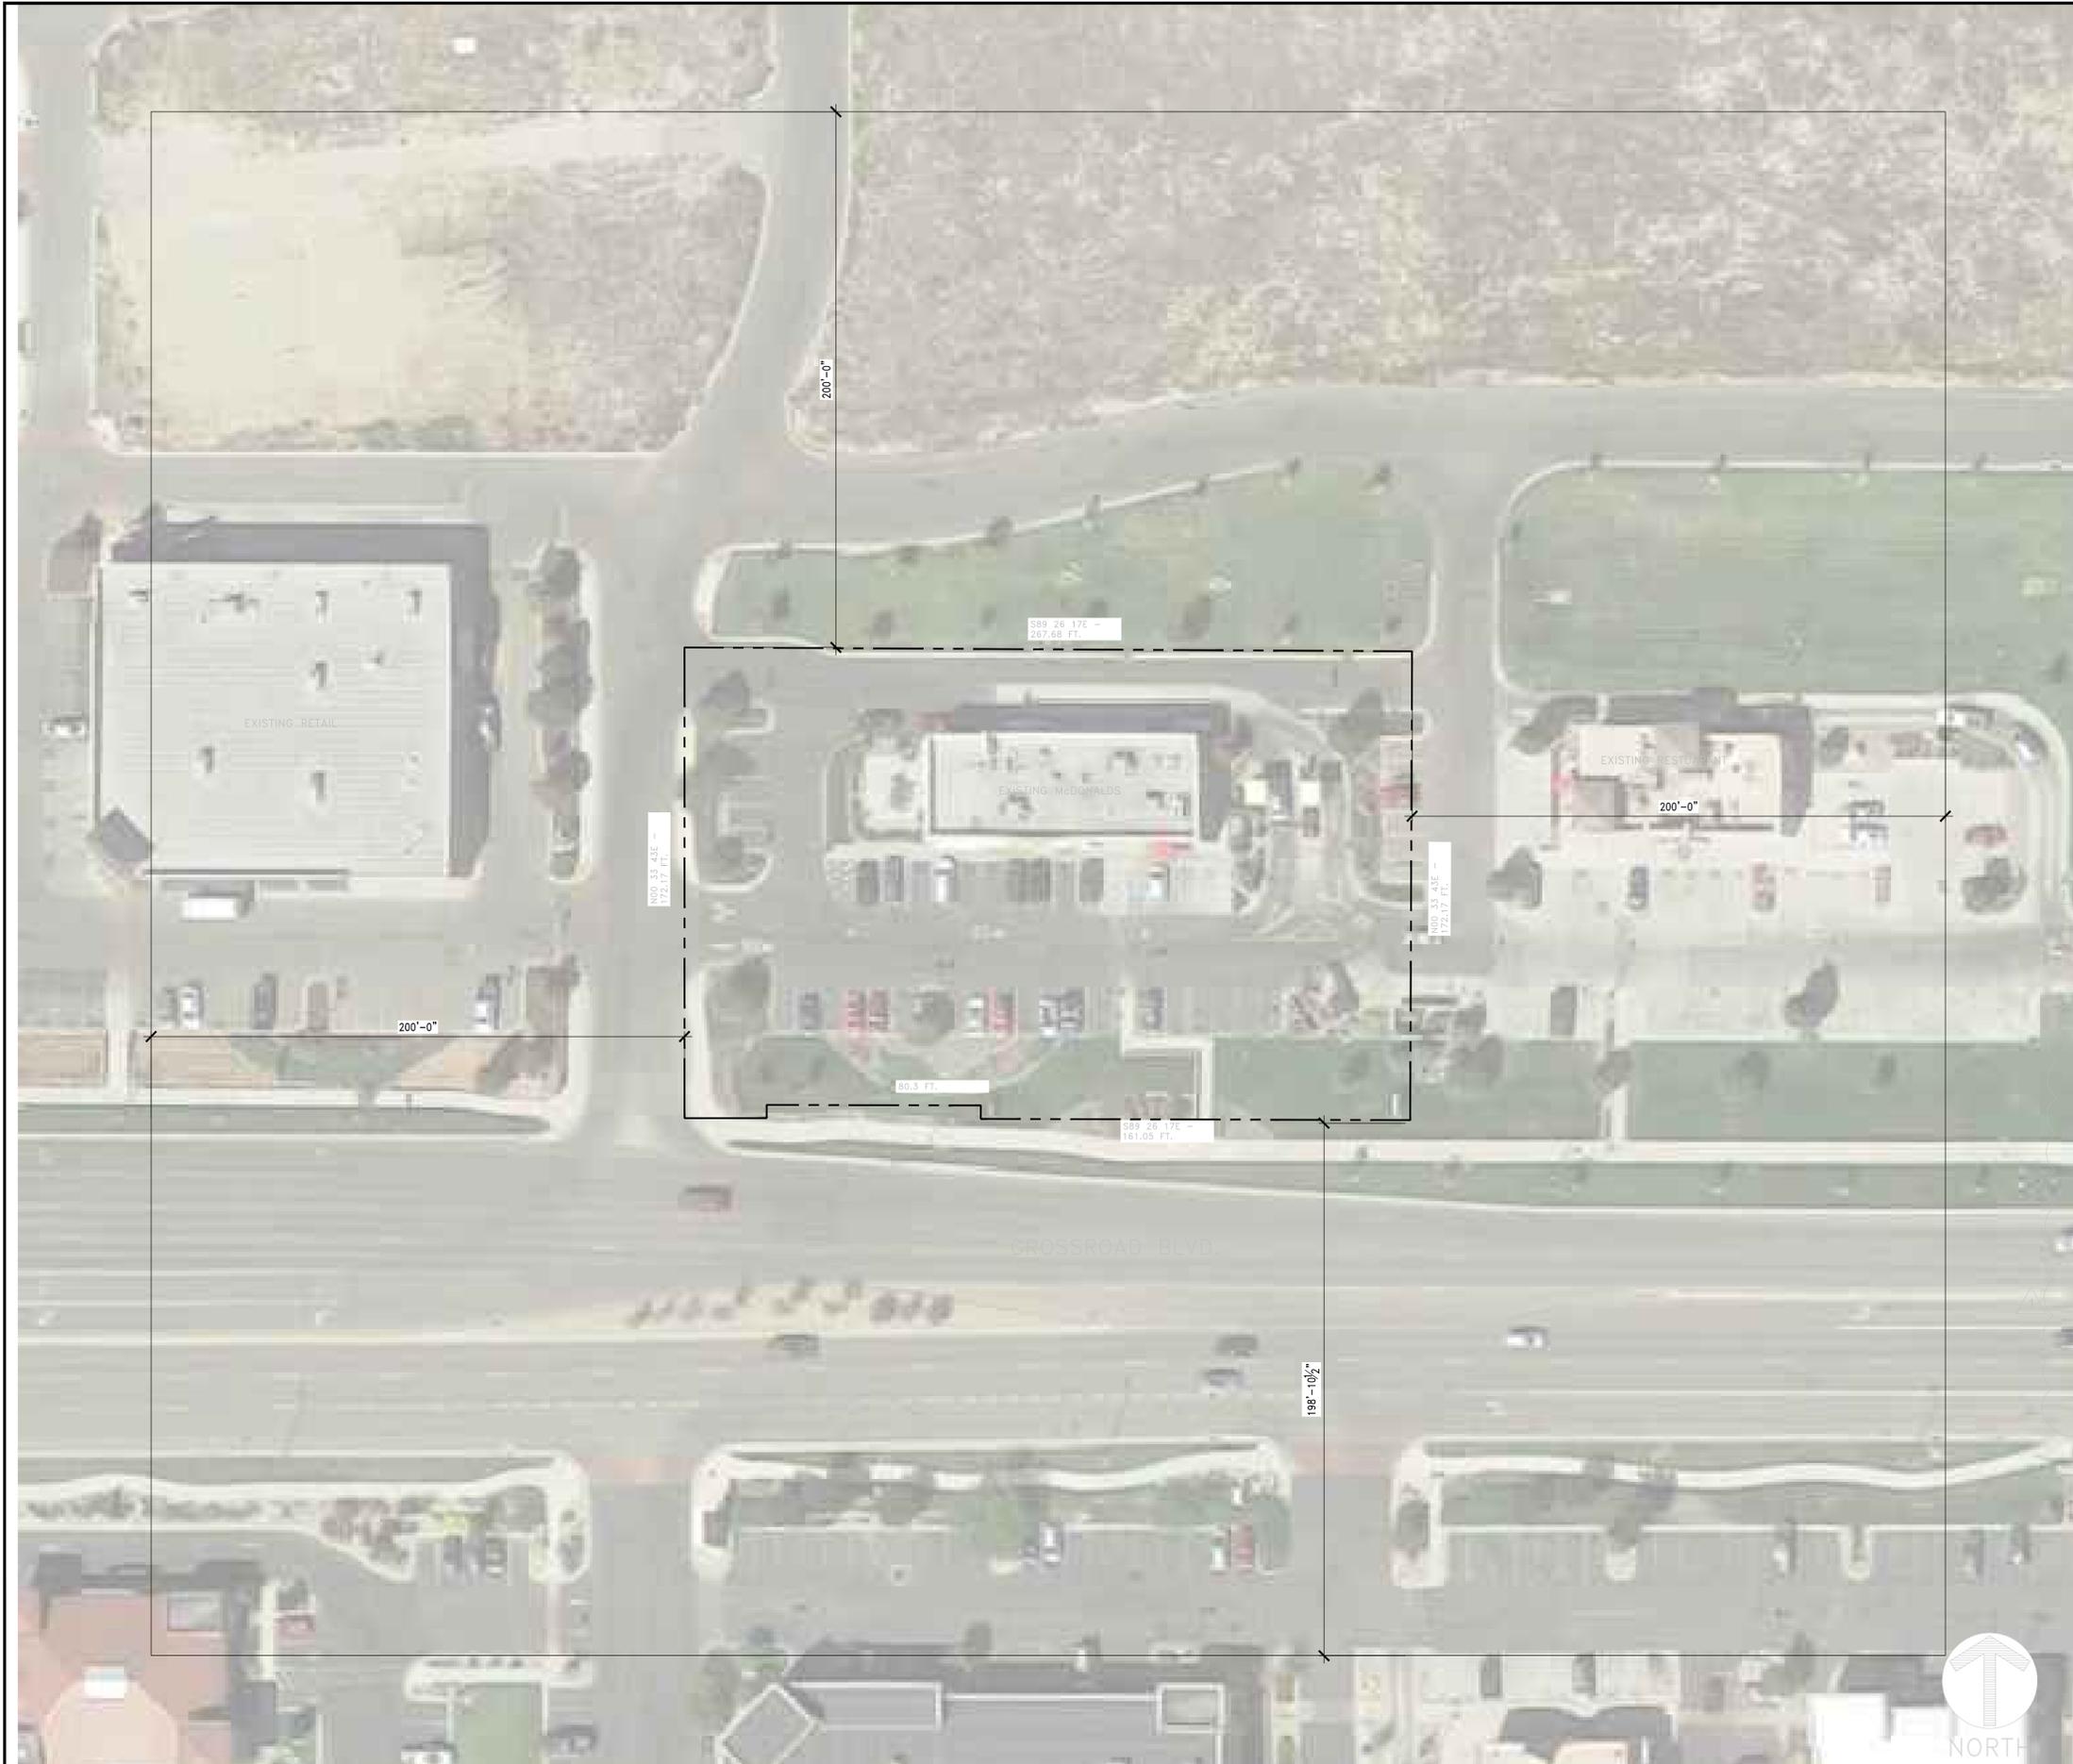

CONTEXT SITE PLAN

SCALE:
1"=30'-0"

KEYED NOTES

REV	DATE	DESCRIPTION
1	09-26-19	PLANNING COMMENTS

NO.	DESCRIPTION OF WORK
1	EXISTING A.D.A. PARKING AND SIGNAGE TO REMAIN.
2	EXISTING SITE LIGHT TO REMAIN.
3	EXISTING MONUMENT SIGN TO REMAIN.
4	EXISTING TRASH ENCLOSURE TO REMAIN.
5	EXISTING PARKING STALL TO REMAIN (TYP.).
6	EXISTING ORDER POINT AND MENU BOARD.
7	EXISTING LANDSCAPE AREA TO REMAIN.
8	EXISTING SIDEWALK TO REMAIN.
9	EXISTING PUBLIC SIDEWALK.
10	EXISTING STONE PATHWAY TO REMAIN.
11	EXISTING A.D.A. RAMP TO REMAIN.
12	EXISTING PRE-BROWSE BOARD TO REMAIN.
13	EXISTING TRANSFORMER TO REMAIN.
14	EXISTING PULL FORWARD PARKING AND SIGNAGE TO REMAIN.
15	EXISTING ACCESSIBLE PATH OF TRAVEL AND SIGN, INDICATING PATH OF TRAVEL FROM PUBLIC RIGHT-OF-WAY TO ACCESSIBLE BUILDING ENTRANCE
16	EXISTING FIRE HYDRANT
17	EXISTING PAINTED PAVEMENT DIRECTIONAL SIGNAGE. TYP.
18	EXISTING MAIN ENTRANCE/EXIT DOOR TO REMAIN.
19	EXISTING SECONDARY ENTRANCE DOOR TO REMAIN.
20	PROPOSED PLAYPLACE TO BE ATTACHED TO EXISTING BUILDING.

PROJECT DATA

APPLICANT / OWNER: MCDONALD'S USA, LLC
17550 N. PERIMETER DRIVE
SUITE 400
SCOTTSDALE AZ 85255
CONTACT: SCOTT AUDSLEY
PHONE: (480) 417-6764
EMAIL: KURTIS.DeMARSE@US.MCD.COM

ARCHITECT: PM DESIGN GROUP, INC.
76 E. MITCHELL DR.
PHOENIX, AZ 85012
CONTACT: STEVEN ALBRECHT
PHONE: (602) 457-4537
EMAIL: SALBRECHT@PMDGINC.COM


ADDRESS: 173 E. CROSSROADS BLVD.
SARATOGA SPRINGS, UT 84043

SCOPE OF WORK:
ADDING PROPOSED 1,027 SQ. FT. PLAY PLACE, VESTIBULE AND FIRE RISER ROOM TO EXISTING MCDONALD'S RESTAURANT. FACADE WILL MATCH EXISTING BUILDING.

SITE DATA

SITE ACREAGE AREA: 45,738 S.F. = 1.05 AC
PARCEL ID: 66:170:0026
EXISTING BUILDING FOOTPRINT: 3,817 S.F.
EXISTING BUILDING COVERAGE: 3,817 S.F. / 45,738 S.F. = 8%
PROPOSED BUILDING ADDITION: 1,027 S.F.
TOTAL EXISTING/PROPOSED BUILDING: 4,844 S.F.
TOTAL BUILDING COVERAGE: 4,844 S.F. / 45,738 S.F. = 11%
EXISTING ZONING: RC - REGIONAL COMMERCIAL
EXISTING BUILDING HEIGHT: 21'-8" (1) STORY
PROPOSED BUILDING HEIGHT: 21'-11" (1) STORY
PARKING (EXISTING TO REMAIN):
EXISTING PARKING: 36 PARKING SPACES
EXISTING ACCESSIBLE PARKING: 2 ACCESSIBLE SPACES
TOTAL EXISTING PARKING: 38 PARKING SPACES
PARKING REQUIRED: 4,844 S.F./250 = 20 PARKING SPACES
ACCESSIBLE PARKING REQUIRED: (1) ACCESSIBLE SPACE.

VICINITY MAP

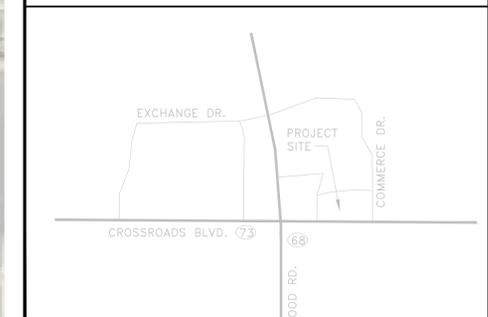

PROFESSIONAL OF RECORD:

HEMANT MODI, ARCHITECT
hmodi@pmdginc.com

STEVEN ALBRECHT, SR. JOB CAPTAIN
salbrecht@pmdginc.com

76 EAST MITCHELL DRIVE,
PHOENIX, ARIZONA 85012
PHONE (623) 432-0596

EXP. 05/31/2020

PREPARED FOR: M. McDonald's USA, LLC
© 2016 McDonald's USA, LLC

THESE DRAWINGS AND SPECIFICATIONS ARE THE CONFIDENTIAL AND PROPRIETARY PROPERTY OF MCDONALD'S USA, LLC AND SHALL NOT BE COPIED OR REPRODUCED WITHOUT THE WRITTEN APPROBATION OF THE CONTRACT DOCUMENTS WERE PREPARED FOR THE PROJECT AND ARE NOT TO BE USED FOR ANY OTHER PROJECT. THE USE OF THESE DRAWINGS FOR REFERENCE OR EXAMPLE ON ANOTHER PROJECT REQUIRES THE SERVICES OF PROPERLY LICENSED ARCHITECTS AND ENGINEERS. REPRODUCTION OF THE CONTRACT DOCUMENTS FOR REUSE ON ANOTHER PROJECT IS NOT AUTHORIZED.

DRAWN BY: SALBRECHT
PROTOTYPE: 38101
REVIEWED BY: JCONSBROCK
DATE ISSUED: 01-31-19
PROJECT#: MCD18018.0

TITLE: McDonald's #31710
SARATOGA SPRINGS

DESCRIPTION: INTERIOR EOTF
PLANNING REVIEW
10/03/19

SITE ID: 043-0267
SITE ADDRESS: 173 E. STATE ROAD 73, SARATOGA SPRINGS, UT 84043

SHEET NO. A0.2
CONTEXT PLAN

KEYED NOTES

1. NEW STOREFRONT SYSTEM. SEE EXTERIOR ELEVATIONS.
2. NEW STOREFRONT DOOR. SEE EXTERIOR ELEVATIONS.
3. NEW OPENING AT EXISTING REMOVED GLAZING.
4. NEW WALL. SEE EXTERIOR ELEVATIONS FOR FINISHES.
5. NEW HOLLOW METAL DOOR AND FRAME FOR FIRE RISER ROOM ADDITION. PAINT TO MATCH ADJACENT FINISH. SEE EXTERIOR ELEVATIONS.

GENERAL NOTES

1. EXTERIOR DIMENSIONS ARE TO EXTERIOR FACE OF FINISH UNLESS OTHERWISE NOTED. INTERIOR DIMENSIONS ARE TO FACE OF FINISH.
2. NOTIFY ARCHITECT OF ANY DISCREPANCIES BETWEEN ARCHITECTURAL AND ELECTRICAL DRAWINGS. OBTAIN CLARIFICATION FROM ARCHITECT IN WRITING BEFORE PROCEEDING WITH THE WORK IN QUESTION OR RELATED WORK.

REV	DATE	DESCRIPTION
2	10-10-19	OWNER REVISIONS


PROFESSIONAL OF RECORD:



HEMANT MODI, ARCHITECT
hmodi@pmdginc.com

STEVEN ALBRECHT, SR. JOB CAPTAIN
salbrecht@pmdginc.com

76 EAST MITCHELL DRIVE,
PHOENIX, ARIZONA 85012
PHONE (623) 432-0596

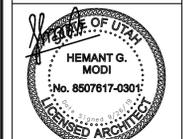


EXP. 05/31/2020

PREPARED FOR:
McDonald's USA, LLC
THESE DRAWINGS AND SPECIFICATIONS ARE THE CONFIDENTIAL AND PROPRIETARY PROPERTY OF MCDONALD'S USA, LLC AND SHALL NOT BE COPIED OR REPRODUCED WITHOUT WRITTEN AUTHORIZATION. THE CONTRACT DOCUMENTS WERE PREPARED FOR THE PROJECT AND ARE NOT TO BE USED FOR ANY OTHER PROJECT. THE USE OF THESE DRAWINGS FOR REFERENCE OR EXAMPLE ON ANOTHER PROJECT REQUIRES THE REPRODUCTION OF PROPERLY LICENSED ARCHITECTS AND ENGINEERS. REPRODUCTION OF THE CONTRACT DOCUMENTS FOR REUSE ON ANOTHER PROJECT IS NOT AUTHORIZED.

DRAWN BY: SALBRECHT
PROTOTYPE: 38101
REVIEWED BY: JCONSBROCK
DATE ISSUED: 01-31-19
PROJECT#: MCD18018.0

TITLE: **McDonald's #31710 SARATOGA SPRINGS**
DESCRIPTION: INTERIOR EOTF
PLANNING REVIEW
10/03/19
SITE ID: 043-0267 173 E STATE ROAD 73, SARATOGA SPRINGS, UT 84043

SHEET NO. **A1.0**
FLOOR PLAN

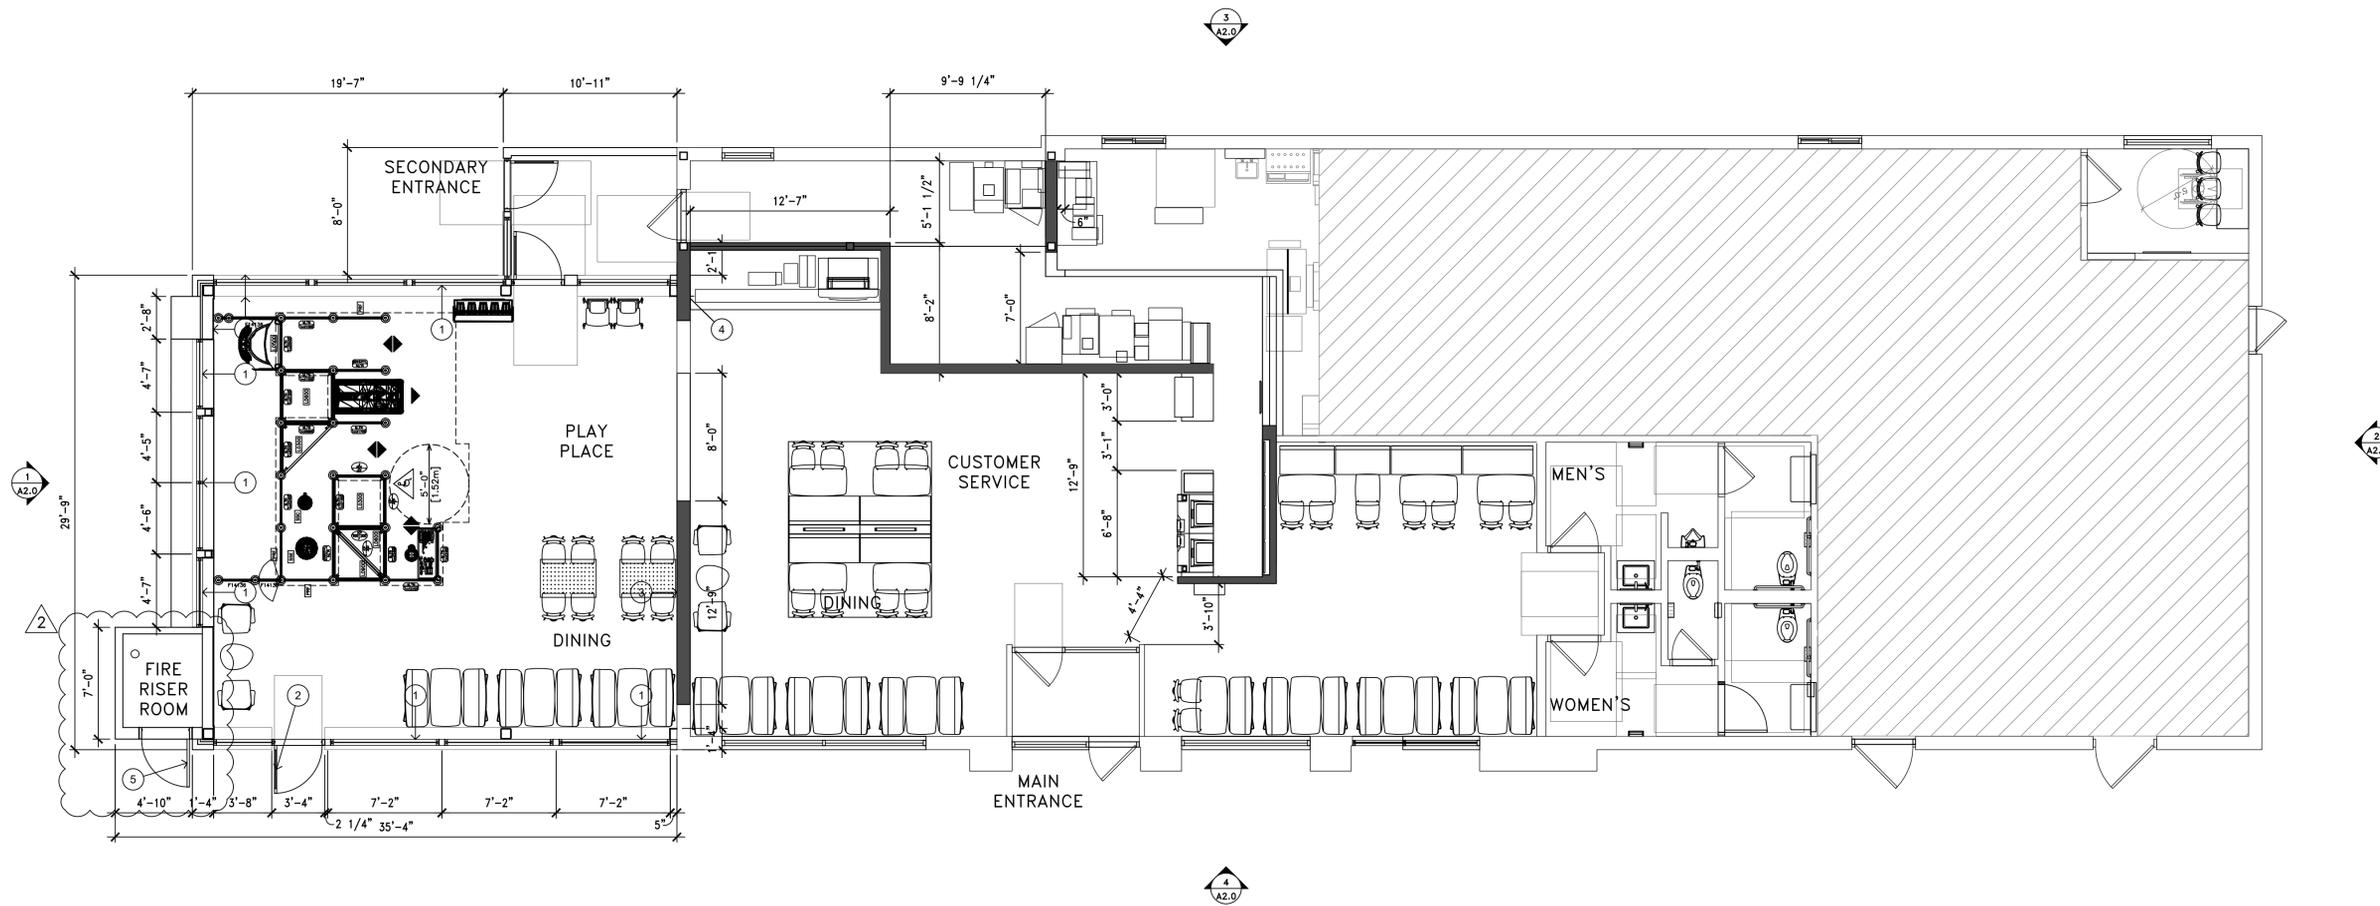


NORTH

FLOOR PLAN SCALE: 3/16"=1'-0" 1

KEYED NOTES

1. REMOVE EXISTING TABLES, BOOTHS AND CHAIRS.
2. REMOVE EXISTING WALL / DECOR WALL IN ITS ENTIRETY.
3. REMOVE EXISTING CUSTOMER SERVICE COUNTER IN ITS ENTIRETY.
4. REMOVE EXISTING RESTROOM ACCESSORIES AND PLUMBING FIXTURES. PATCH WALL AS REQUIRED AT REMOVED RECESSED FIXTURES.
5. REMOVE SELF-SERVE BEVERAGE COUNTER.
6. OUTDOOR SEATING TO BE REMOVED.
7. REMOVE STOREFRONT SYSTEM IN ITS ENTIRETY.
8. REMOVE STOREFRONT DOOR FOR NEW GLAZING TO MATCH EXISTING.

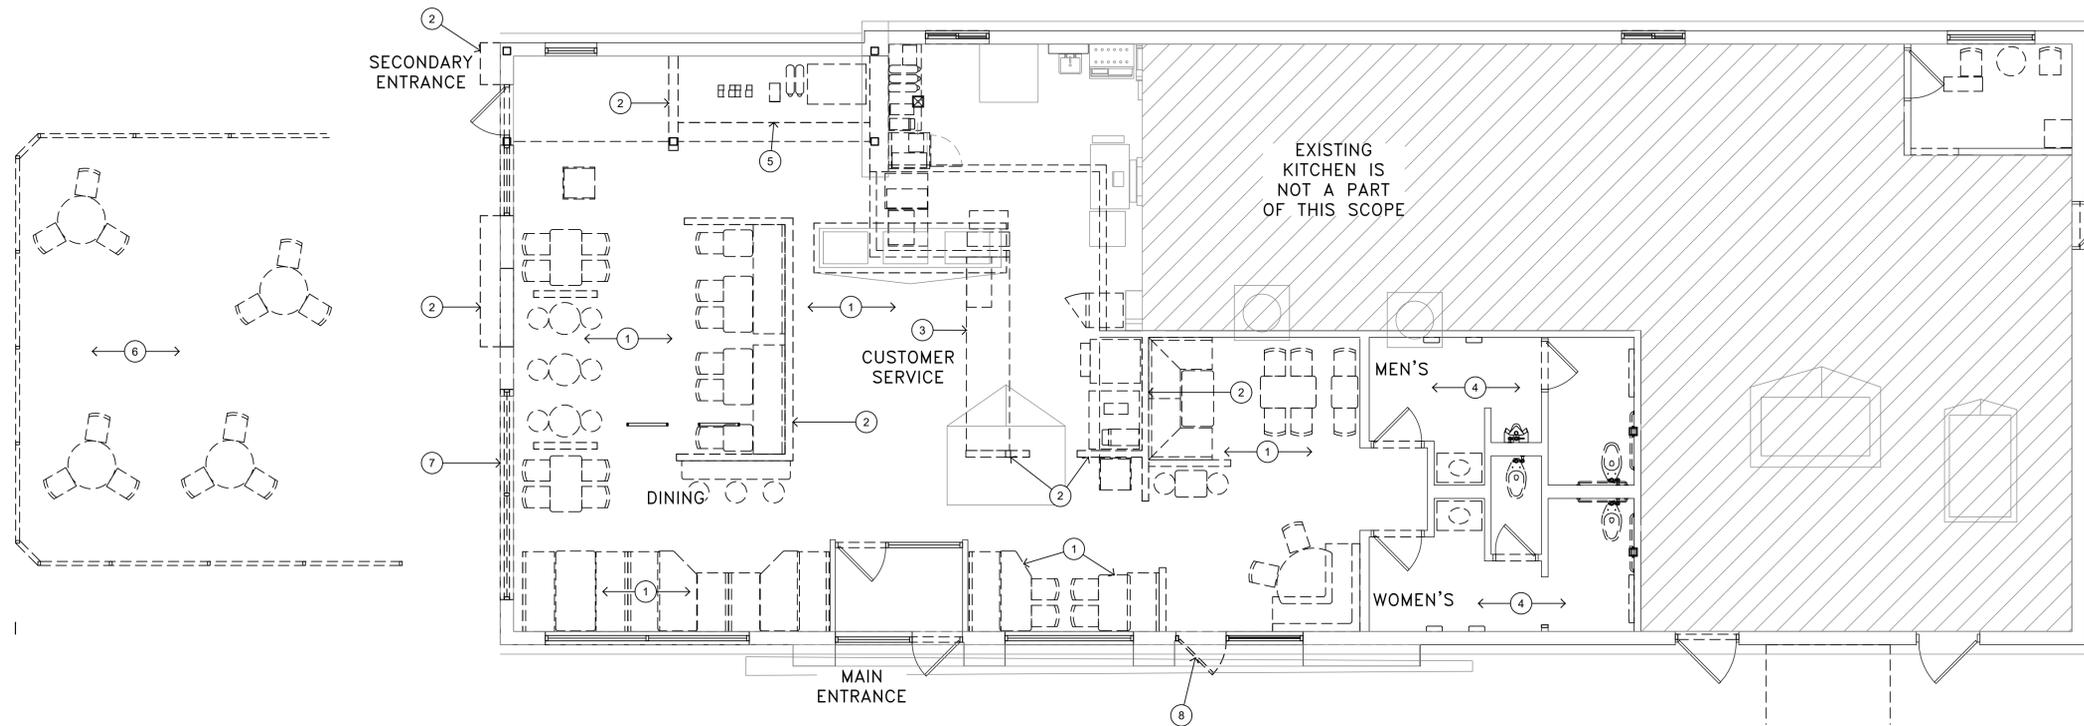

REV	DATE	DESCRIPTION
1	09-26-19	PLANNING COMMENTS

PROFESSIONAL OF RECORD:



HEMANT MODI, ARCHITECT
hmodi@pmdginc.com

STEVEN ALBRECHT, SR. JOB CAPTAIN
salbrecht@pmdginc.com

76 EAST MITCHELL DRIVE,
PHOENIX, ARIZONA 85012
PHONE (623) 432-0596



EXP. 05/31/2020

PREPARED FOR: **McDonald's USA, LLC**
 THESE DRAWINGS AND SPECIFICATIONS ARE THE CONFIDENTIAL AND PROPRIETARY PROPERTY OF MCDONALD'S USA, LLC AND SHALL NOT BE COPIED OR REPRODUCED WITHOUT WRITTEN AUTHORIZATION. THE CONTRACT DOCUMENTS WERE PREPARED FOR THE PROJECT AND ARE NOT TO BE USED FOR ANY OTHER PROJECT. THE USE OF THESE DRAWINGS FOR REFERENCE OR EXAMPLE ON ANOTHER PROJECT REQUIRES THE SERVICES OF PROPERLY LICENSED ARCHITECTS AND ENGINEERS. REPRODUCTION OF THE CONTRACT DOCUMENTS FOR REUSE ON ANOTHER PROJECT IS NOT AUTHORIZED.

DRAWN BY	SALBRECHT
PROTOTYPE	38101
REVIEWED BY	JCONSBRUCK
DATE ISSUED	01-31-19
PROJECT #	MCD18018.0


SHEET NO.	1
TITLE	McDonald's #31710 SARATOGA SPRINGS
DESCRIPTION	INTERIOR EOTF
PLANNING REVIEW	10/03/19
SITE ID	043-0267
SITE ADDRESS	173 E STATE ROAD 73, SARATOGA SPRINGS, UT 84043




NORTH

DEMO FLOOR PLAN SCALE: 3/16"=1'-0"

A1.0a
DEMO FLOOR PLAN

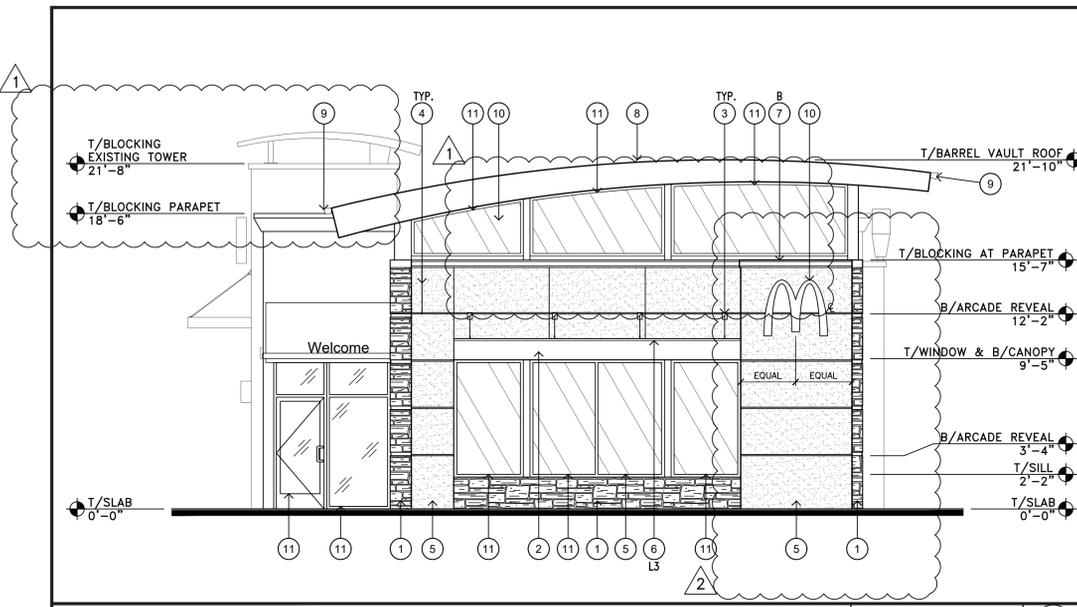

PROPOSED WEST ELEVATION SCALE: 3/16" = 1'-0" 1

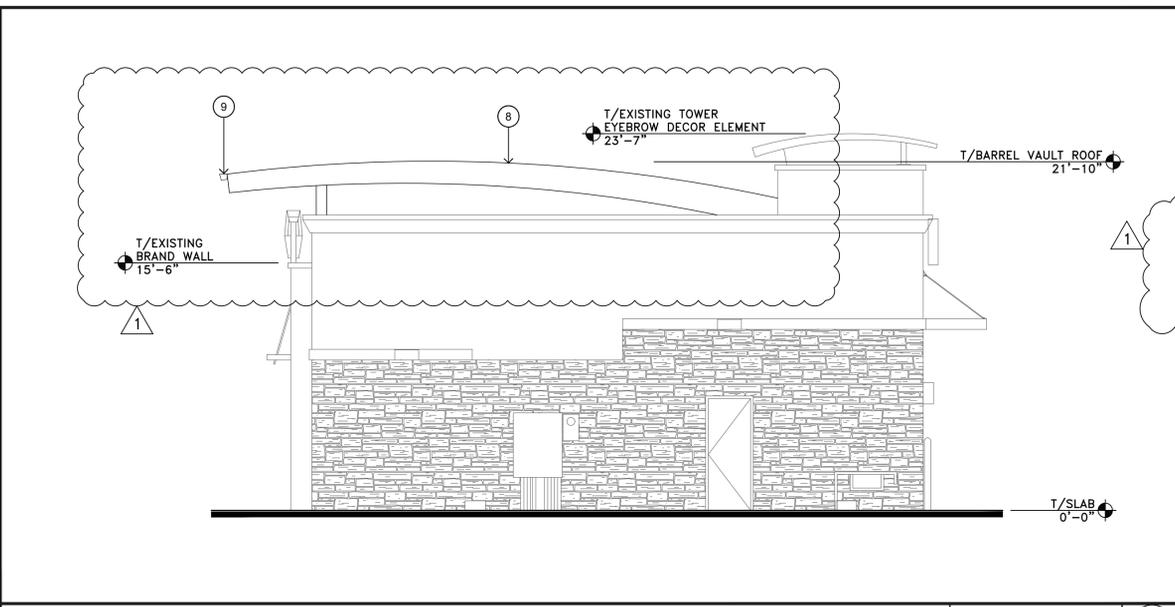


PROPOSED EAST ELEVATION SCALE: 3/16" = 1'-0" 2


- ### KEYED NOTES
- STONE VENEER. COLOR TO MATCH ADJACENT.
 - ALUMINUM CANOPY SYSTEM. COLOR: GOLD.
 - ALUMINUM CANOPY TIE-BACK SYSTEM.
 - CONTROL JOINT (E.I.F.S.).
 - EXTERIOR INSULATION FINISH SYSTEM (E.I.F.S.). COLOR = BENJAMIN MOORE 2122-70 SNOW WHITE.
 - ACCENT LED LIGHTING L3 INTEGRAL CANOPY FIXTURE. GE CANOPY FASCIA LED
GEMM2450-W1 93053667 (200/BOX) GELCORE TETRA MINI MAX WARM WHITE 5000K (B) 4 LED PER MODULE, 8 LED PER FOOT, 2 MODULES PER FOOT
 - METAL FASCIA - COLOR TO MATCH CORRUGATED METAL PANEL.
A = PRE-FAB ANCHOR-TIE FASCIA.
B = PRE-FAB CUSTOM ARCADE FASCIA.
C = PRE-FAB MASONRY CAP FASCIA.
 - METAL ROOF - STANDING SEAM W/ALUMINUM FINISH FASCIA TRIM. COLOR: GOLD - PANTONE COLOR #123C.
 - CONTINUOUS RAIN GUTTERS AT BARREL VAULT ROOF. COLOR TO MATCH ROOF.
 - MCDONALD'S SIGNAGE BY OTHERS - UNDER SEPARATE PERMIT.
 - EXTERIOR WINDOW ASSEMBLY - TEMPERED GLASS.
 - BREAK METAL. COLOR: CITYSCAPE BY METAL - ERA.
 - ALUMINUM CANOPY SYSTEM.
 - METAL LOUVER PANEL.
 - EIFS CORNICE TO MATCH EXISTING.
 - HOLLOW METAL DOOR AND FRAMING FOR FIRE RISER ROOM ADDITION. PAINT TO MATCH ADJACENT WALL.

NOTE:

- PRIOR TO PAINTING THE BUILDING, CONTRACTOR TO PROVIDE 4' x 4' MINIMUM MOCK-UP OF ALL EXTERIOR PAINT COLORS, ON ACTUAL MATERIALS AND FINISHES, FOR ARCHITECT'S AND OWNER'S ON SITE APPROVAL.
- SIGNAGE UNDER SEPARATE PERMIT.

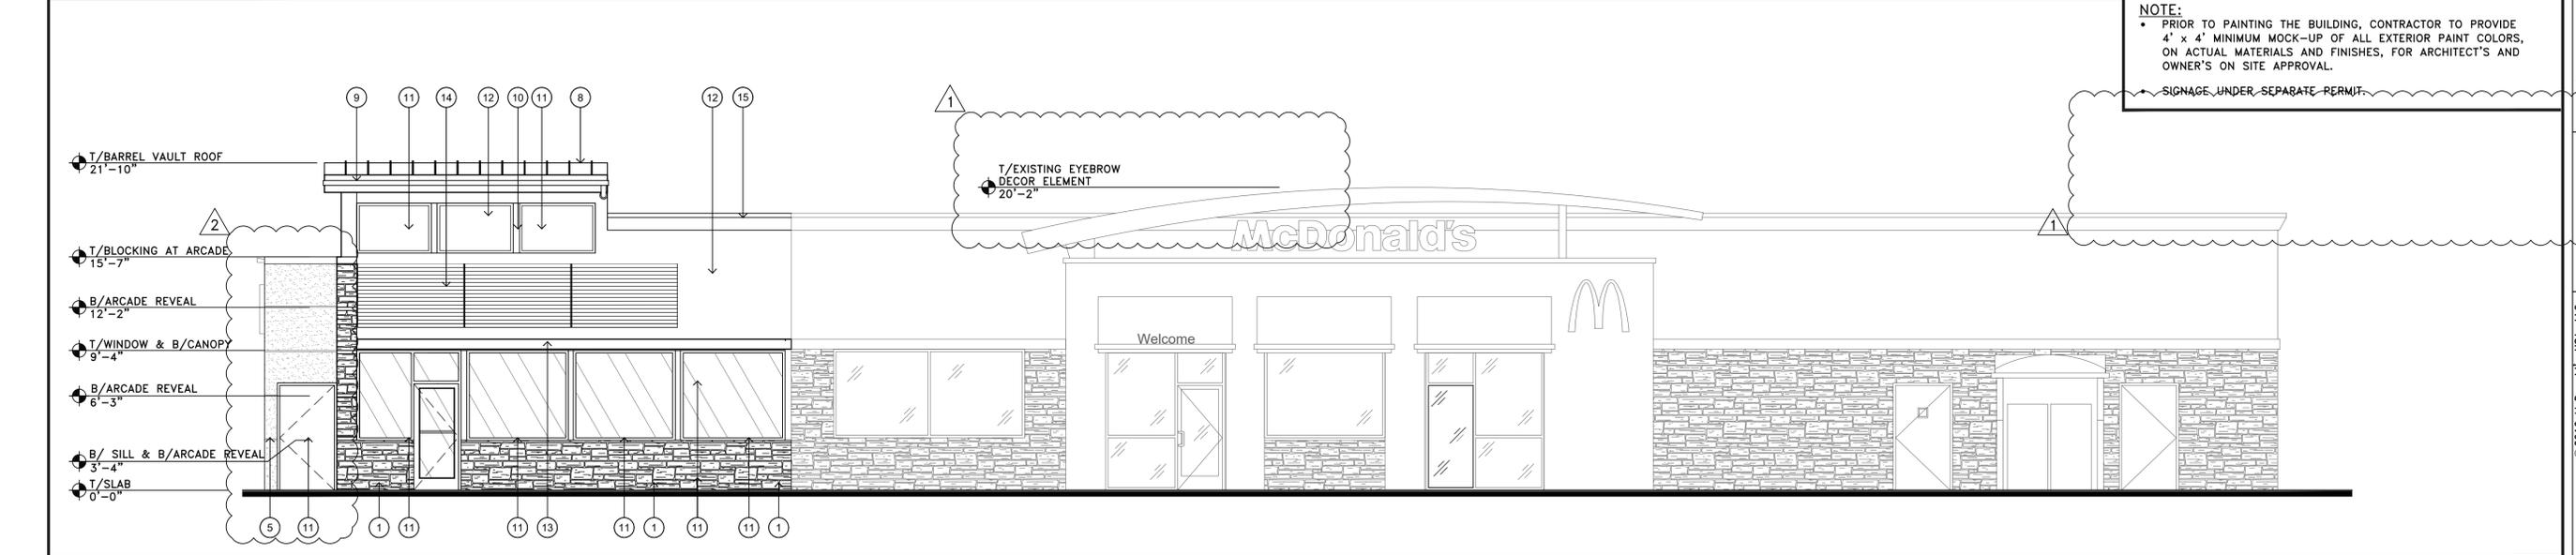

PROPOSED SOUTH ELEVATION SCALE: 3/16" = 1'-0" 3

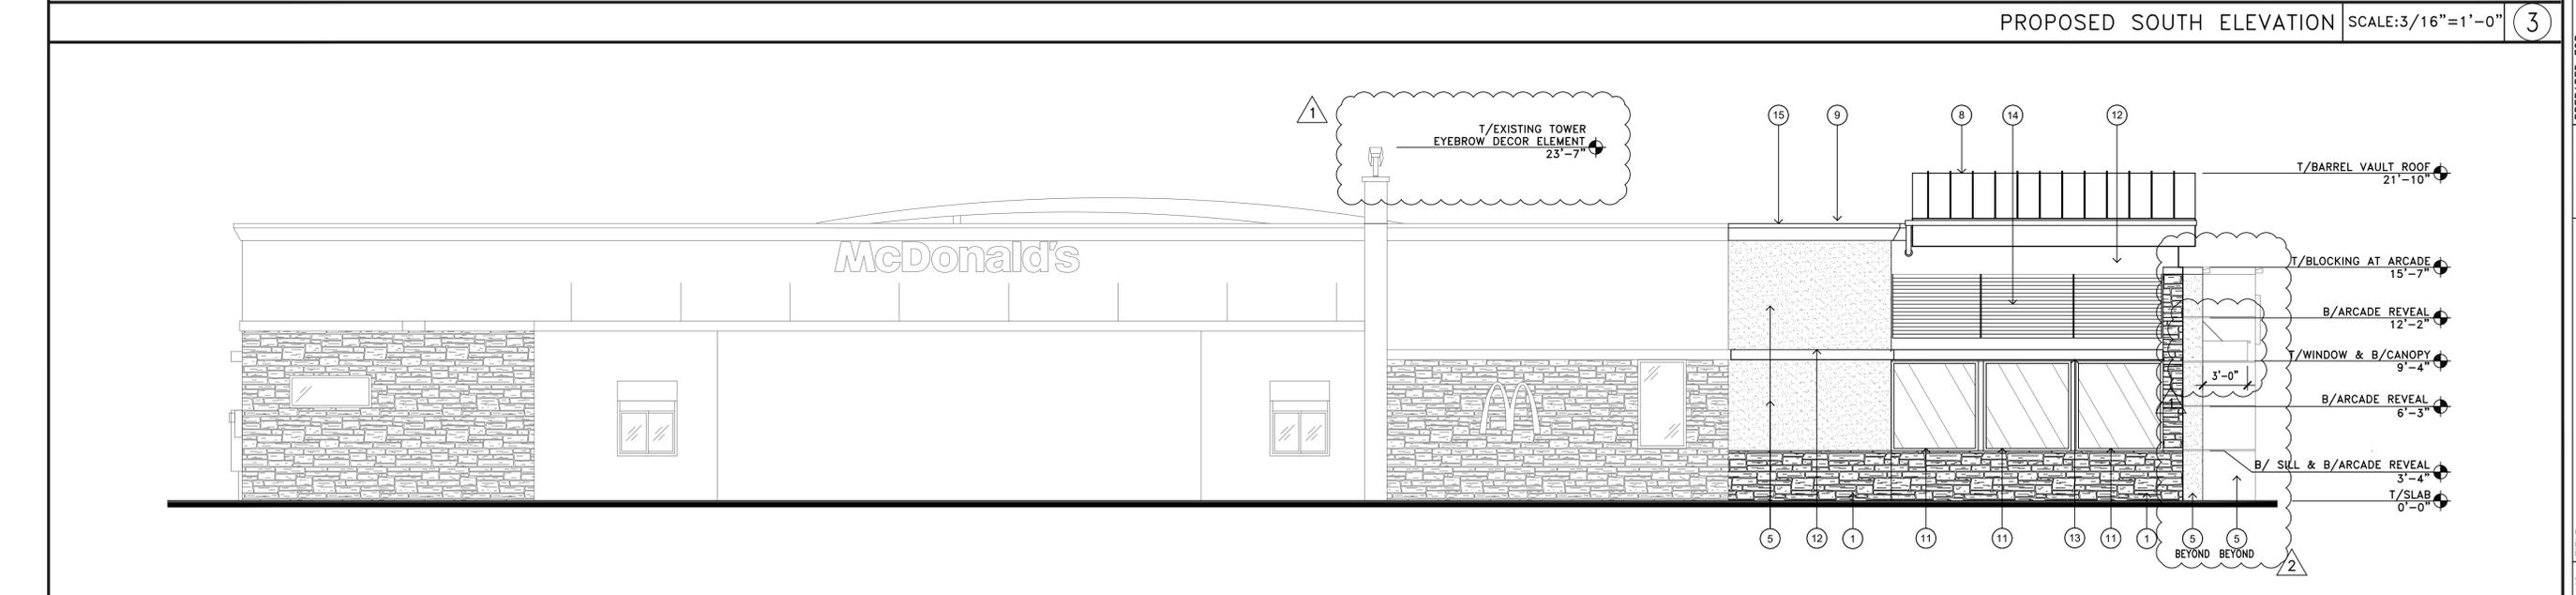

PROPOSED NORTH ELEVATION SCALE: 3/16" = 1'-0" 4

REV	DATE	DESCRIPTION
1	09-26-19	PLANNING COMMENTS
2	10-10-19	OWNER REVISIONS

PROFESSIONAL OF RECORD:

PM DESIGN
Architectural Solutions Group

HEMANT MODI, ARCHITECT
hmodi@pmdginc.com

STEVEN ALBRECHT, SR. JOB CAPTAIN
salbrecht@pmdginc.com

76 EAST MITCHELL DRIVE,
PHOENIX, ARIZONA 85012
PHONE (623) 432-0596

STATE OF UTAH
HEMANT G. MODI
No. 8507817-0301
LICENSED ARCHITECT

EXP. 05/31/2020

PREPARED FOR:
McDonald's USA, LLC

© 2016 McDonald's USA, LLC
THESE DRAWINGS AND SPECIFICATIONS ARE THE CONFIDENTIAL AND PROPRIETARY PROPERTY OF MCDONALD'S USA, LLC AND SHALL NOT BE COPIED OR REPRODUCED WITHOUT WRITTEN AUTHORIZATION. THE CONTRACT DOCUMENTS WERE PREPARED FOR THE PROJECT DESCRIBED HEREIN AND ARE NOT TO BE USED FOR ANY OTHER PROJECT. DRAWINGS FOR REFERENCE OR EXAMPLE ON ANOTHER PROJECT REQUIRES THE SERVICES OF PROPERLY LICENSED ARCHITECTS AND ENGINEERS. REPRODUCTION OF THE CONTRACT DOCUMENTS FOR REUSE ON ANOTHER PROJECT IS NOT AUTHORIZED.

DRAWN BY	REVIEWED BY	DATE ISSUED	PROJECT #
SALBRECHT	JCONSBRUCK	01-31-19	MCD18018.0
PROTOTYPE			

TITLE: **McDonald's #31710 SARATOGA SPRINGS**

DESCRIPTION: INTERIOR EOTF
PLANNING REVIEW
10/03/19

SITE ID: 043-0267 173 E STATE ROAD 73, SARATOGA SPRINGS, UT 84043

SHEET NO. **A2.0**
PROPOSED ELEVATIONS